


**LEGEND**

- 200mm dia
- 160mm dia
- 110mm dia
- 90mm dia
- FIRE HYDRANT
- ⊠ ISOLATING VALVE

**NOTE:**  
 1. ALL VALVES OVER SPLAY.  
 2. ALL FIRE HYDRANTS OVER PEG.

VAAL RIVER

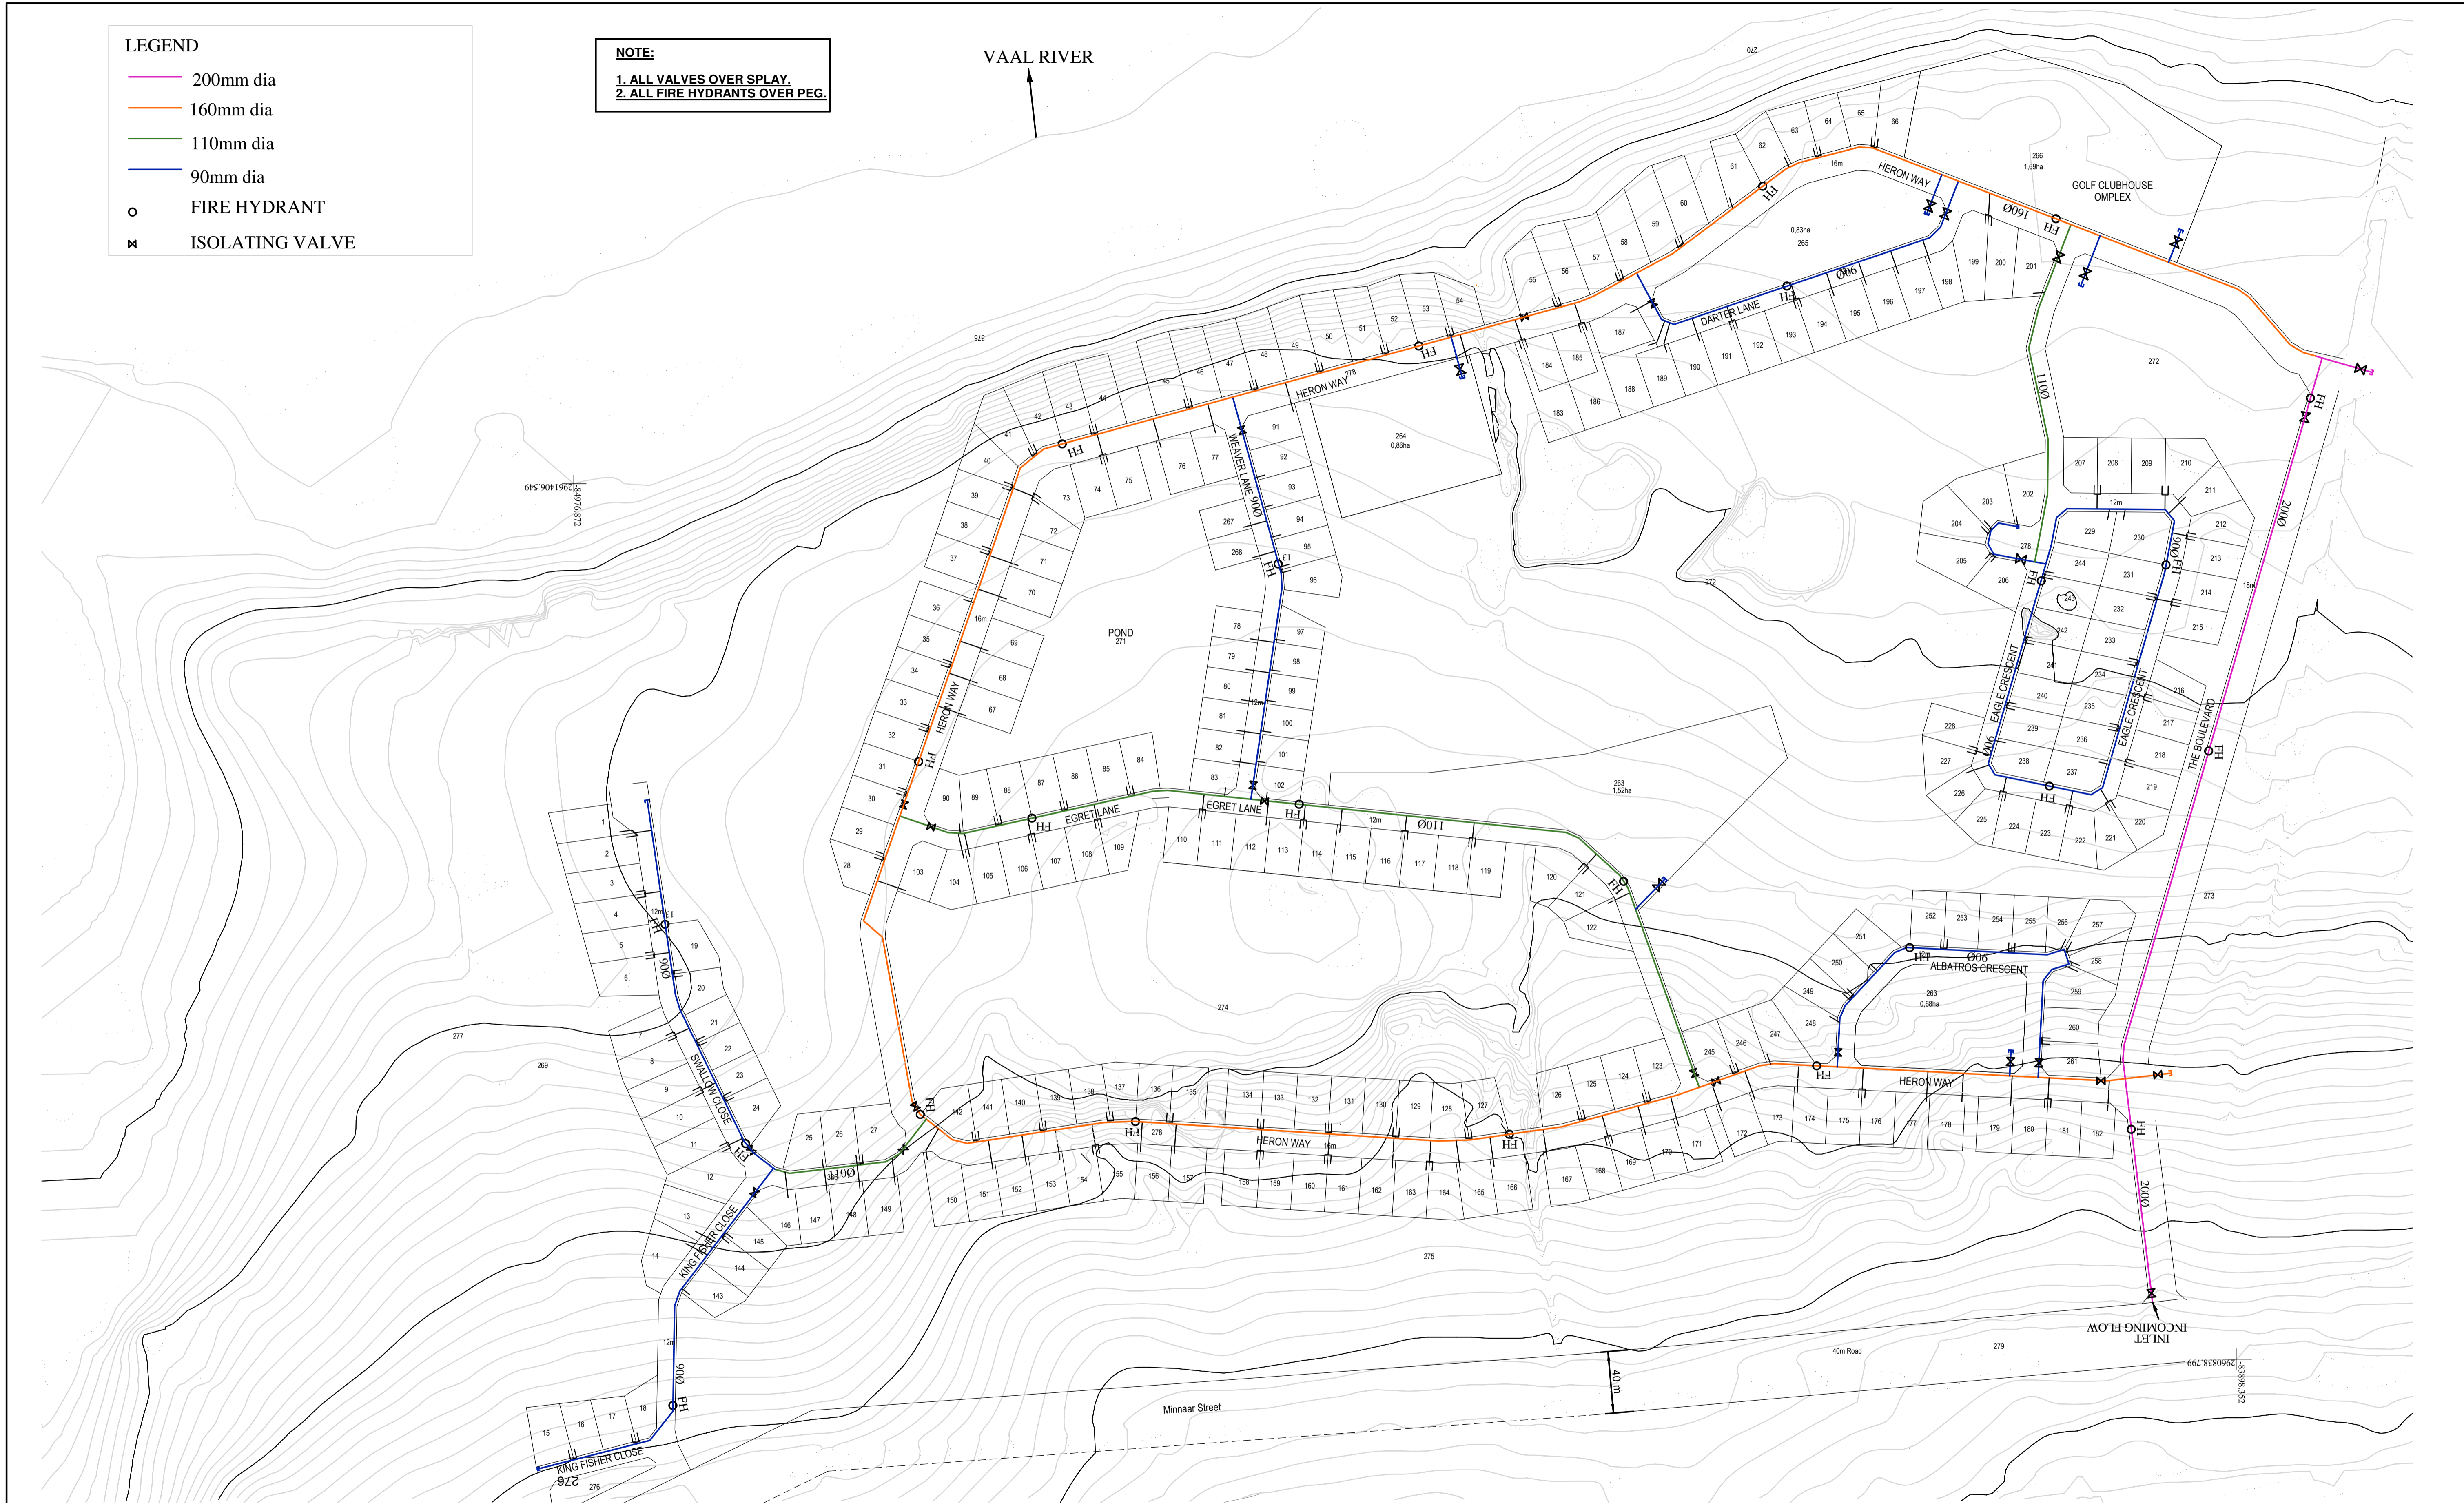

**ILIFA Africa Engineers (Pty) Ltd**  
 PRETORIA: 012-362 1473  
 HARRISMITH: 058-022 1297  
 SASOLBURG: 016-976 0850  
 VANDERBULPARK: 016-981 0591  
 KRUGERSDORP: 011-365 5334  
 RICHARDSBAY: 035-753 1083  
 GEORGE: 044-871 0043  
 DUNDEE: 034-212 1205  
 SECUNDA: 017-534 8895

**15 Roseberry Street,  
 PO Box 1184,  
 Sasolburg, 1947.**

**ASSOCIATED OFFICES:**  
 BETHLEHEM, BRITS, MTUBATUBA, NELSPRUIT, PHALABORWA.

Amendments		
0	SHORT DESCRIPTION OF REVISION DONE	BY DATE
1		

**HERON BANKS  
 COMPANY (PTY) Ltd**

**heron banks**  
 GOLF AND RIVER ESTATE

HERON BANKS GOLF & RIVER ESTATE, ROADS & SERVICES  
 SEWER NETWORK AS BUILT  
 SEWER LAYOUT

**METSIMAHOLO LM  
 VAALPARK: SASOLBURG**

Scale	1:2000	AS BUILT	
Date	14-01-2009	Drawing Number	Rev
Drawn	CR	S06/W57/01	AB
Designed	MH	Checked	
Plot ini	ilifa1	Approved	
File Name	S06S5701 - HERONBANKS - WATER LAYOUT - AB		